

STATE OF CALIFORNIA - DEPARTMENT OF TRANSPORTATION

DESIGN OVERSIGHT

BEHZAD GOLEHAMMADI

CALCULATED/DESIGNED BY

CHECKED BY

DATE 01/0

DATE 01/0

REVISED BY

DATE REVISED

NOTES:

- This plan sheet is a record drawing from Skyway Structures contract. The Contractor shall verify the existing installation. See sheet EE-96 from the Skyway Structures Contract No. 04-012024.
- The installed components shall not be limited to the ones listed below, but shall be a complete installation. For details, see Bridge Structures Girder Eastbound, typical Details sheets.
 - Furnish and install 15 kV cables into existing cable tray shown on this drawing. Refer to riser diagram on E-837.
 - Furnish and install TOS fiber optic cables into existing cable tray shown on this drawing. Refer to riser diagram on E-983.
 - Inspect for system ground continuity. See sheets E-839 and E-840.
- All cable trays shown on this drawing are existing. Bold ones are to be used for pulling cable.

SHEET NOTES:

- 1 For Service Platform #21E details, see sheet E-834.
- 2 Furnish and install splice cable tray as shown on sheet E-836, plan detail 2.

REQUEST FOR INFORMATION NOT ADDRESSED IN THIS CCO REMAIN IN FORCE					
	03/08/10	MEP INTEGRATION	SYC	FW	110
MARK	DATE	DESCRIPTIONS	BY	CH'D	CCO#
REVISIONS					

CONTRACT CHANGE ORDER NO. _____
SHEET _____ OF _____


BRIDGE STRUCTURES GIRDER EASTBOUND
SKYWAY STRUCTURES
SCALE: 1:200

E-815

THIS PLAN ACCURATE FOR ELECTRICAL WORK ONLY.

ALL DIMENSIONS ARE IN METERS UNLESS OTHERWISE SHOWN


FOR REDUCED PLANS ORIGINAL
SCALE IS IN MILLIMETERS

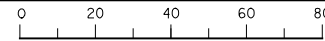

DGN FILE =>04-0120f1_E-815.dgn
USERNAME =>ilorico

CU 04251

EA 0120F1

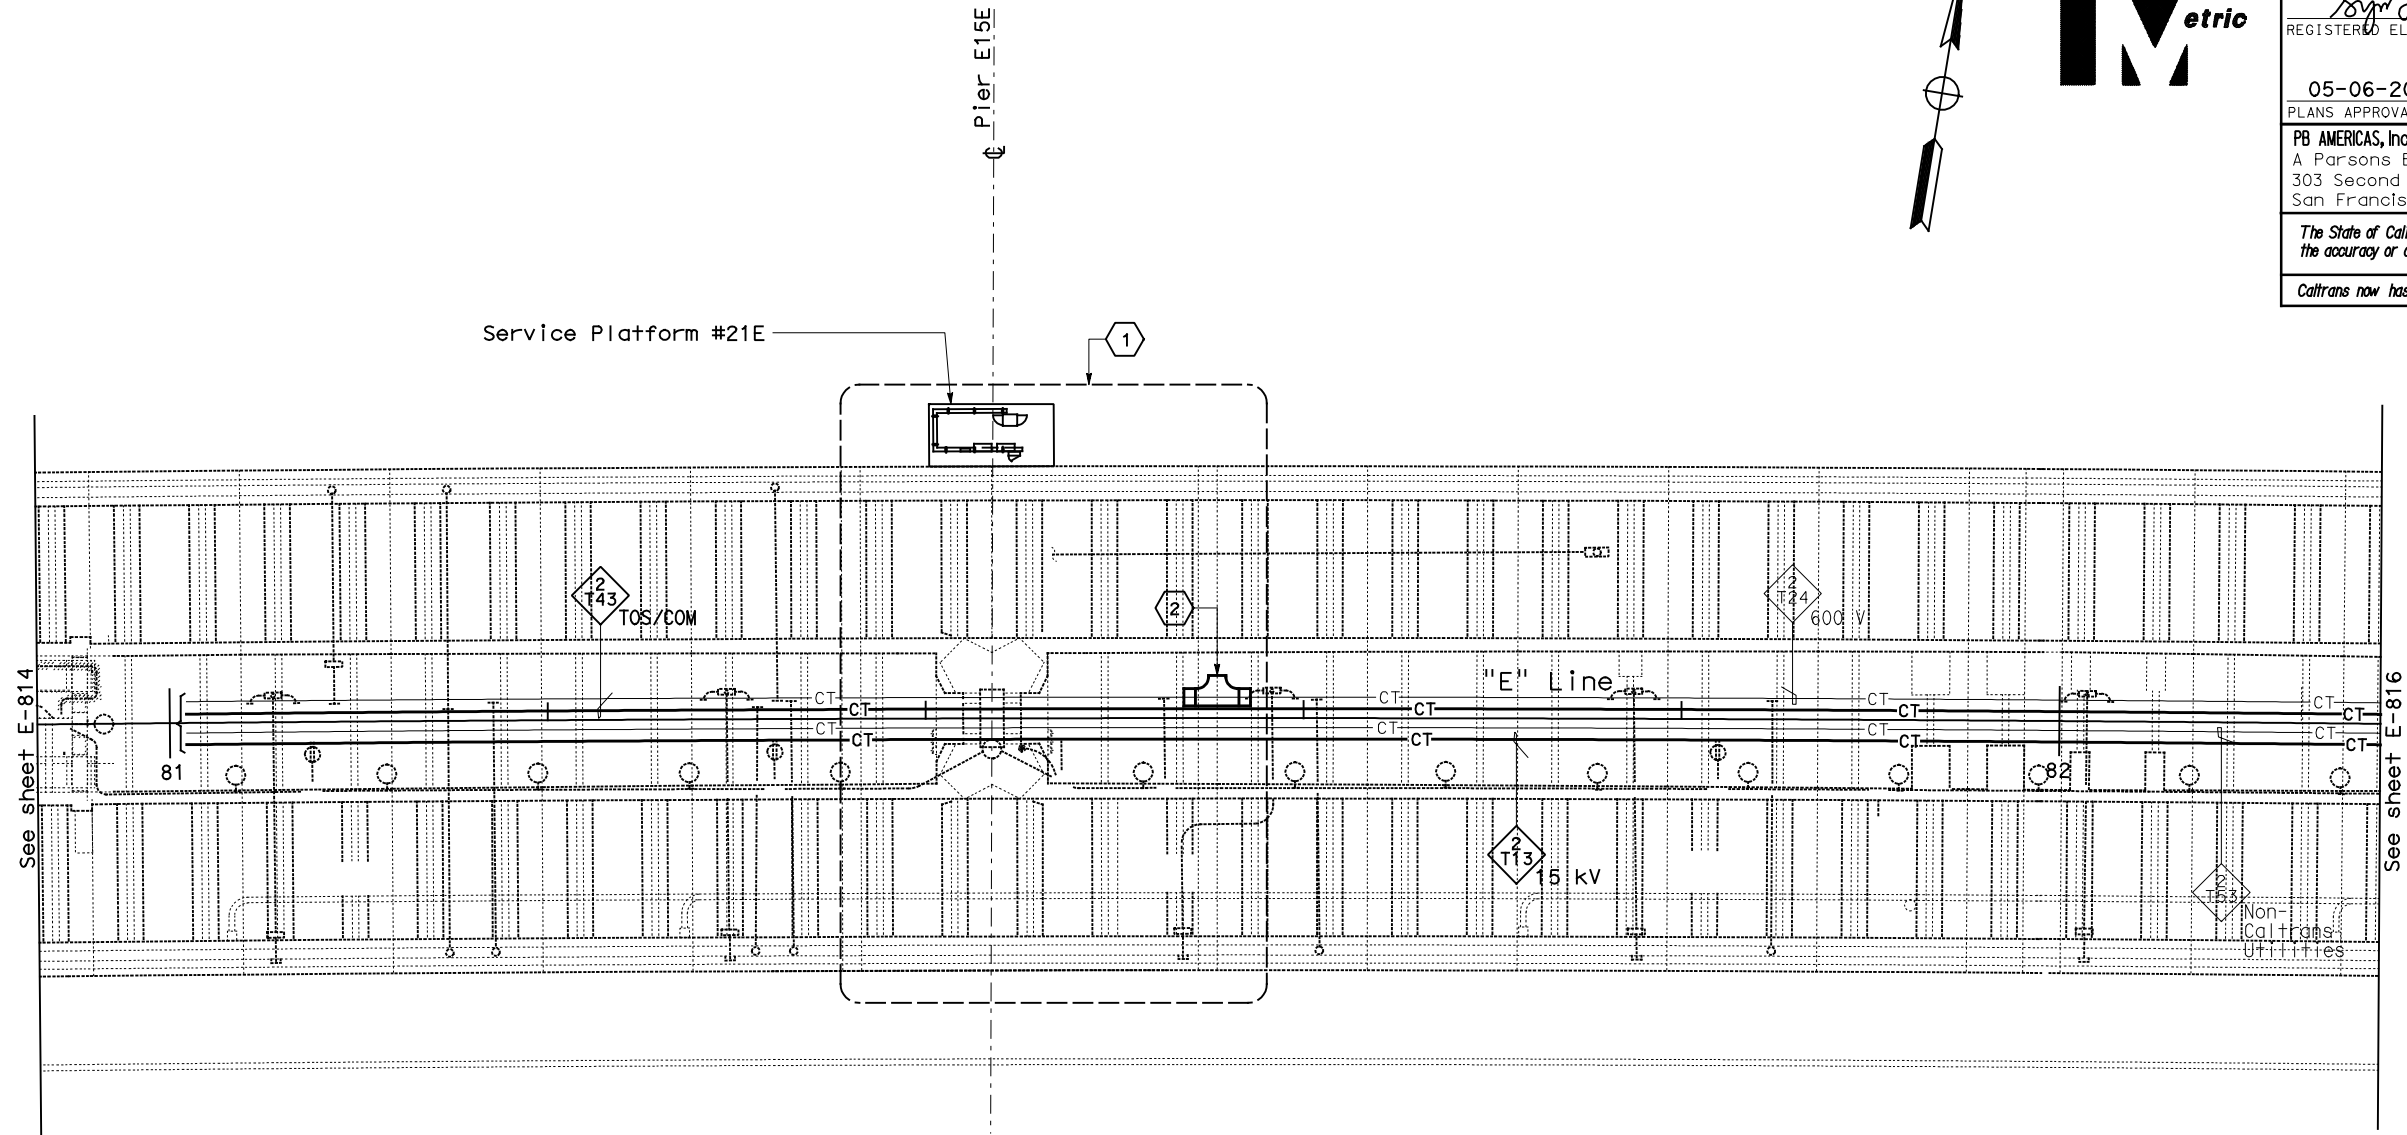

CONDUIT AND CABLE TRAY PLAN

DIST COUNTY ROUTE KILOMETER POST TOTAL PROJECT SHEET No TOTAL SHEETS

04 SF,Ala 80 12.2/14.3 0.0/4.0 407a 08S16 1204

REGISTERED ELECTRICAL ENGINEER DATE

03/08/10

05-06-2010

PLANS APPROVAL DATE

PB AMERICAS, Inc.

A Parsons Brinckerhoff Company

303 Second St., Suite 700N

San Francisco, CA 94107-1317

The State of California or its officers or agents shall not be responsible for the accuracy or completeness of electronic copies of this plan sheet.

Caltrans now has a web site. To get to the web site, go to <http://www.dot.ca.gov>

REGISTERED PROFESSIONAL ENGINEER

SYN YEE CHIN

No. 18186

Exp. 09/30/2011

ELECTRICAL

STATE OF CALIFORNIA

DATE PLOTTED => 06-MAY-2010
TIME PLOTTED => 18:24
LAST REVISION
00-00-00